

leave

STATE OF UTAH
DEPARTMENT OF NATURAL RESOURCES
DIVISION OF OIL, GAS AND MINING
1594 West North Temple - Suite 1210
Box 145801
Salt Lake City, Utah 84114-5801
Telephone: (801) 538-5291
Fax: (801) 359-3940

RECEIVED
RECEIVED
JAN 30 2014
JAN 30 2014
DIV. OF OIL, GAS & MINING
DIV. OF OIL, GAS & MINING

LARGE MINING OPERATIONS PROGRESS REPORT

January 1, 2013 to December 31, 2013

The information required in this form is based on provisions of the Mined Land Reclamation Act, Title 40-8, and the R647 rules under the Utah Minerals Regulatory Program.

1. Mine Permit Number: M/051/0013
2. Mine Name: Center Creek Quarry
3. Name of Operator/Permittee: Geneva Rock Products, Inc.

Note: If Operator's address, company representative or phone number have changed, please provide a replacement page for the Notice of Intention together with form MR-REV available on the Division's web page at https://fs.ogm.utah.gov/pub/mines/minerals_related/forms/MR-REV.pdf.

4. Report the gross amount of ore mined and waste moved:

Gross Ore Mined 0 Tons, or 0 yd³
Waste Material Moved 0 Tons, or 0 yd³


5. Disturbance at the end of 2012 13.00 Acres
New Disturbance Created during 2013 0 Acres
Area Reclaimed and Fully Released during 2013 0 Acres
Total Disturbed Area at the end of 2013 13.00 Acres*
Permitted/Bonded Acreage 64.00 Acres
*The total disturbed area should not be greater than the permitted/bonded acreage

6. Briefly describe the reclamation work performed during the past year. (Submit form MR-SITE (https://fs.ogm.utah.gov/pub/mines/minerals_related/forms/MR-SITE.pdf) to apply for full or partial bond/site release). Attach additional sheets if needed.
No reclamation work has been performed during this period.

7. For large mines, include an updated map depicting surface disturbance and reclamation performed during the year (Rule R647-4-105).

I hereby certify, under penalties of law, the information provided in this report is true and correct to the best of my knowledge and belief.

Name (Typed or Print): Brent R. Sumsion
Title of Operator: Properties and Environmental Manager
Signature of Operator: [Signature]
Date: 1-28-14

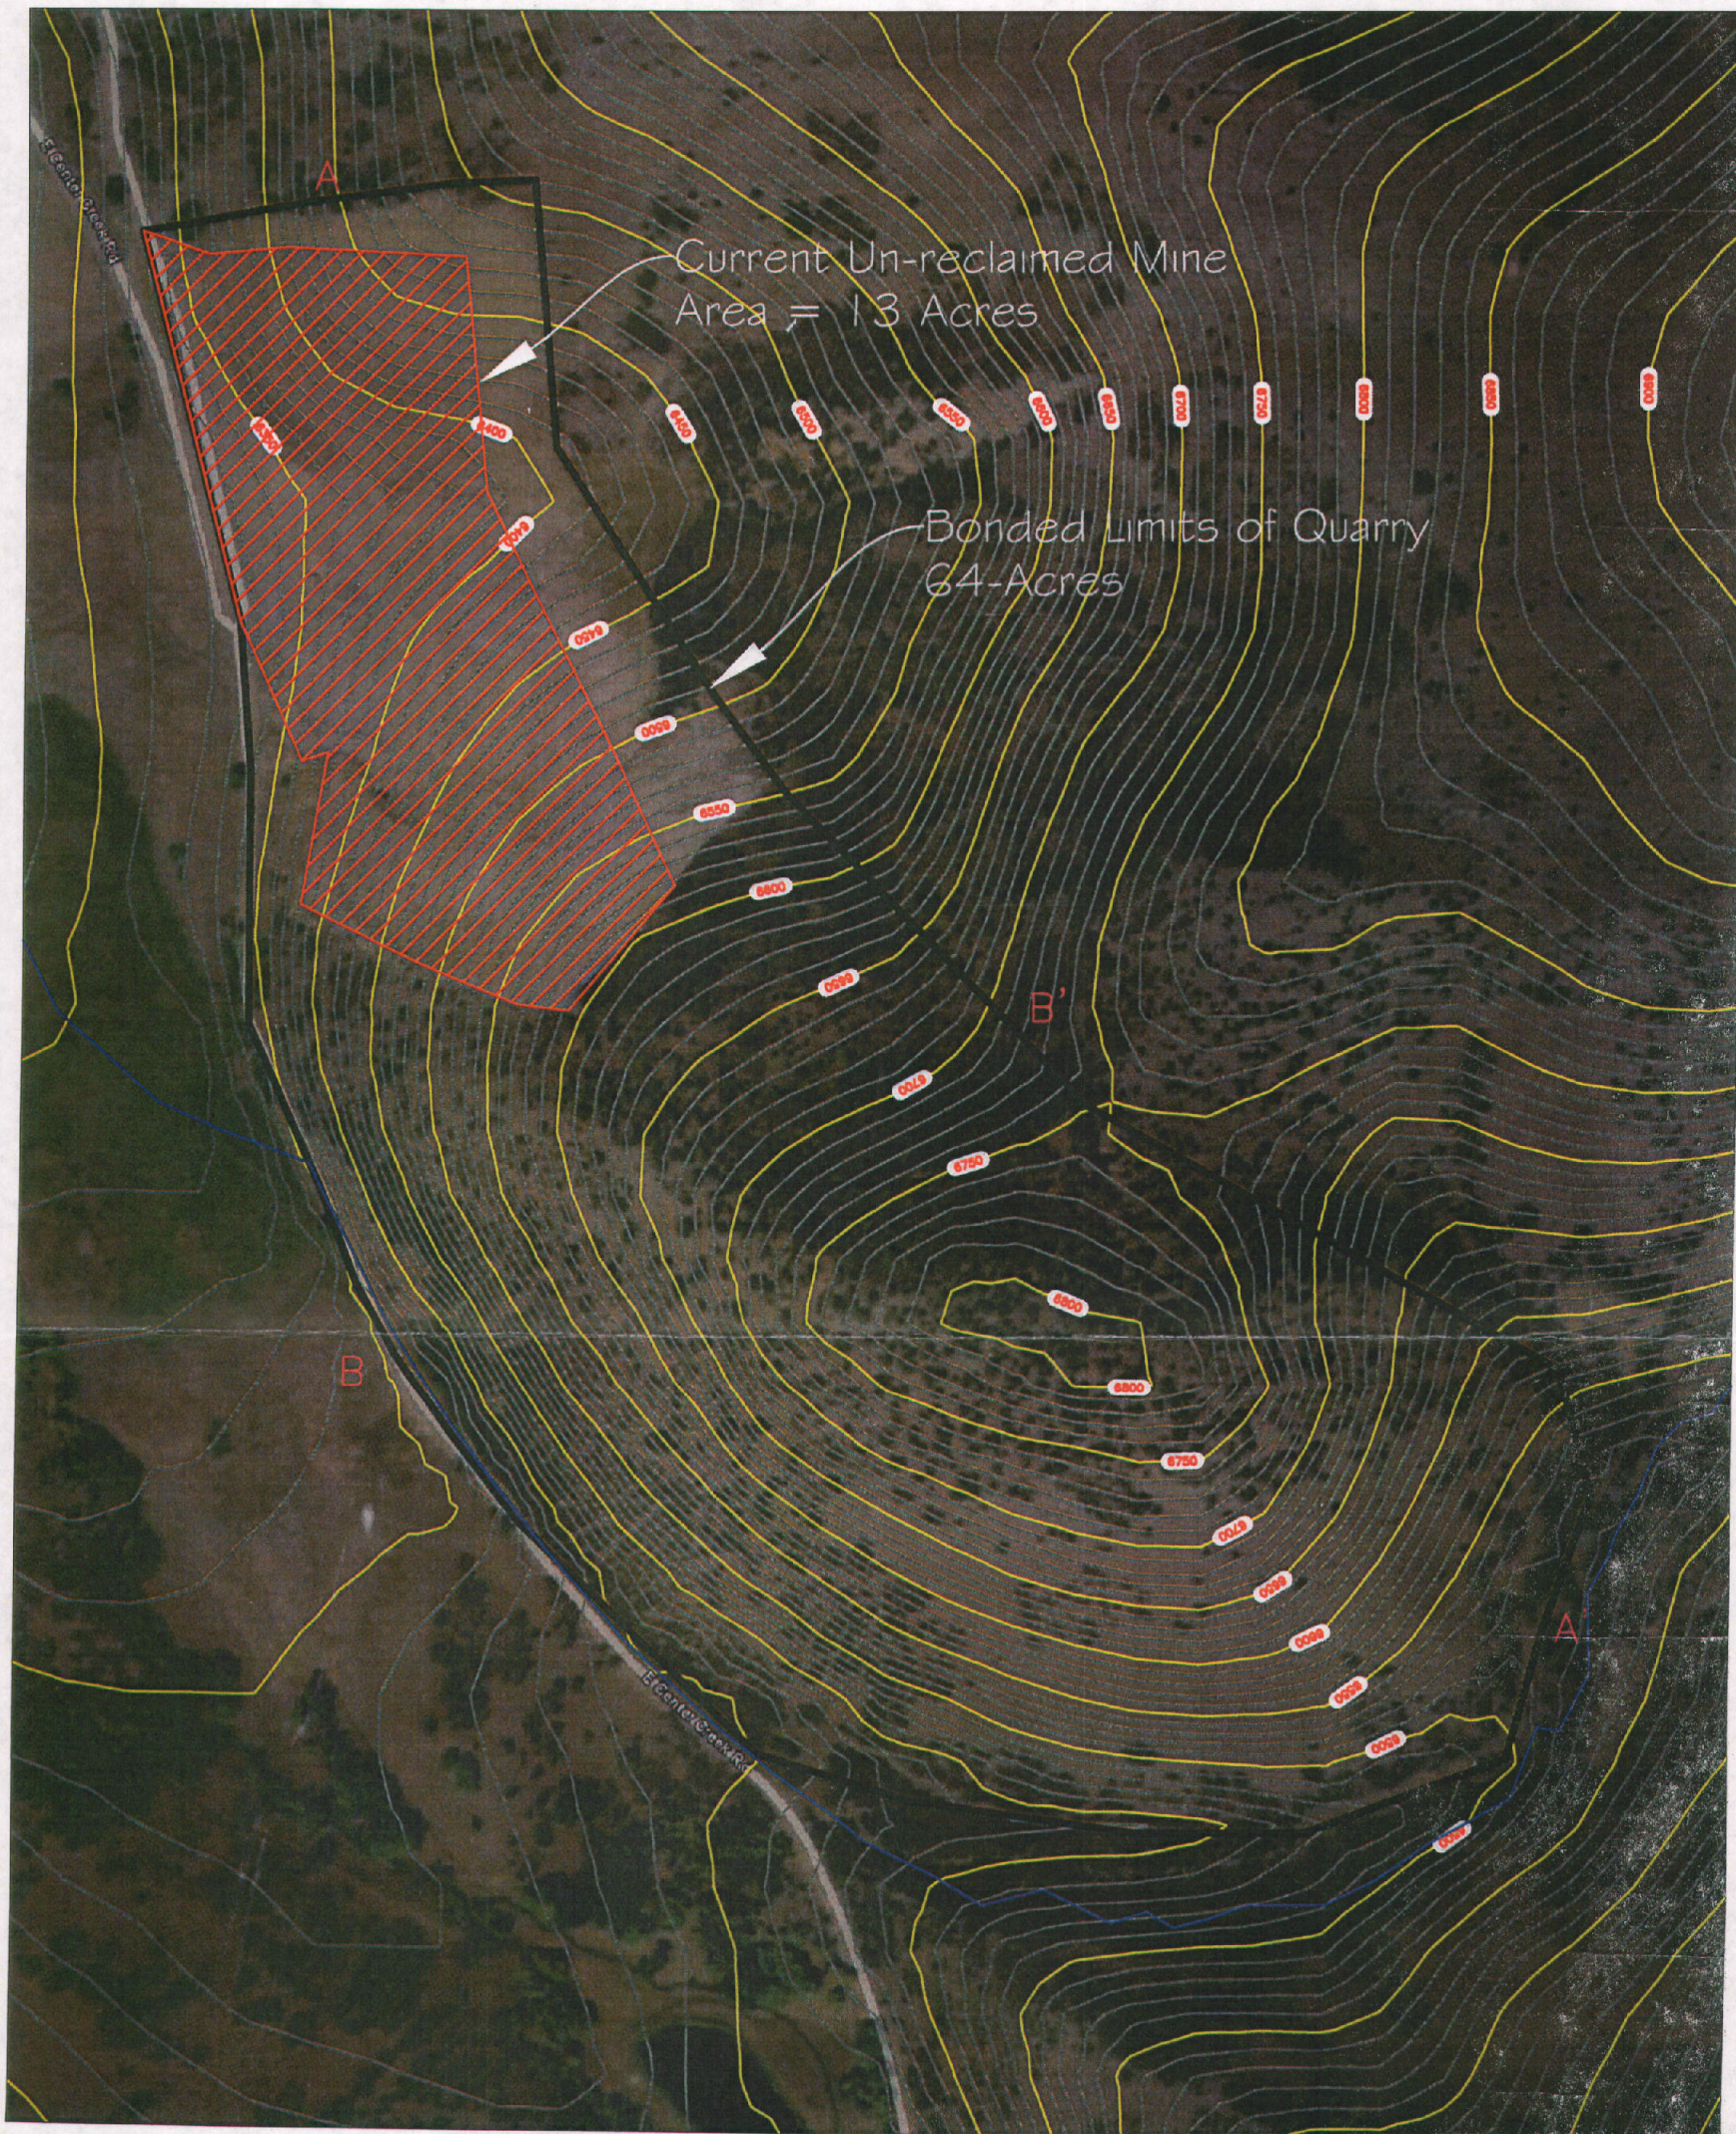

Legend



Major 50' Contour

Minor 10' Contour

Water Course

Quarry Bdy

Existing Mine Footprint

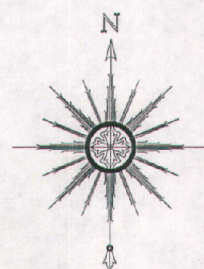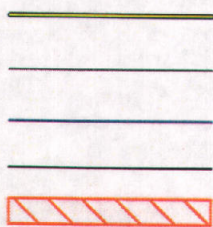

Scale 1"=300'

Drawn: B SUMSON
Checked: BS/CC
Approved:
Date: 12-17-09
Dwg. No.

TITLE: Center Creek Quarry
DOGM NOI
Figure 3
ISSUED FOR INTERNAL REVIEW
Revision: 00

Engineer:
NO. DATE: DESCRIPTION: BY:

Geneva Rock Center Creek Quarry
Original Contours



Geneva Rock Products, Inc.
1556 West 400 North
Orem, Utah 84057
801-765-7800